



1 FIRST FLOOR  
Scale: 1/16" = 1'-0"

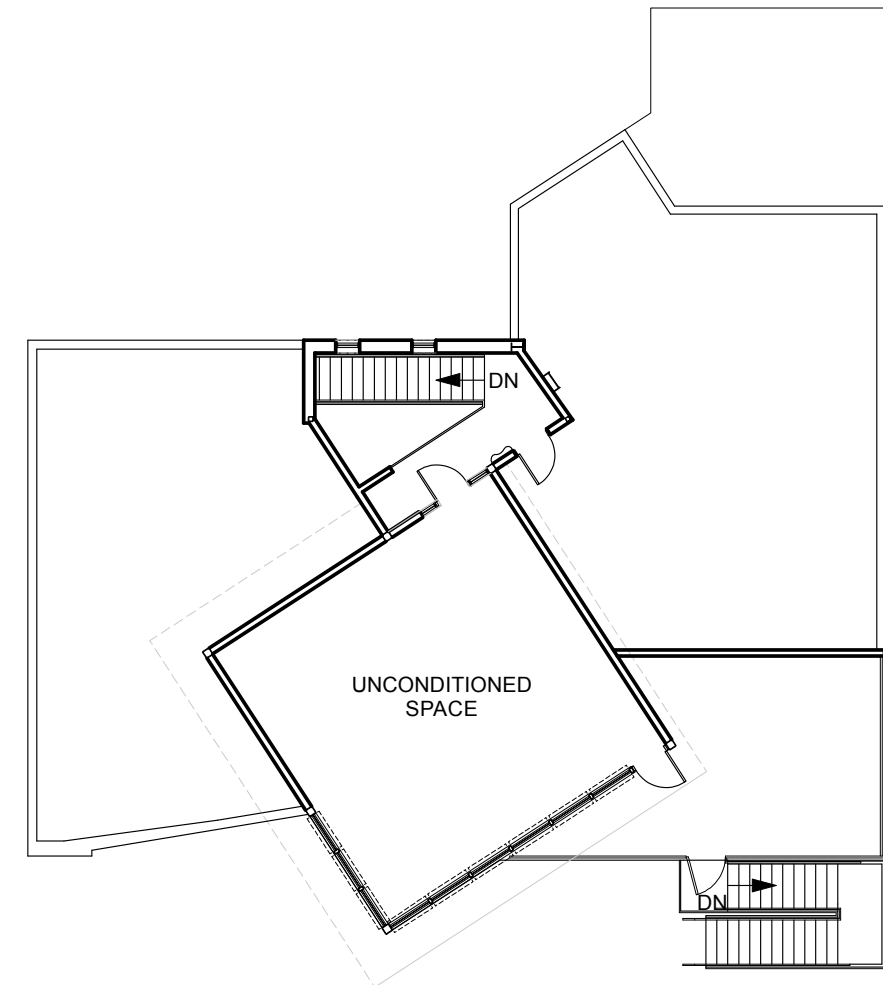

2 SECOND FLOOR  
Scale: 1/16" = 1'-0"

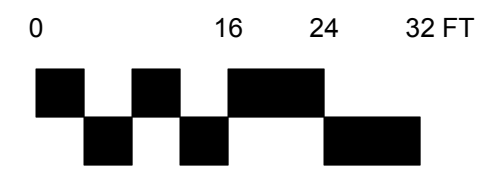

**2451 PEACHTREE RD NE**  
ATLANTA, GA 30305

1359 La France St  
Unit A  
Atlanta, GA 30307  
404-653-0553 p  
404-653-0025 f

